BORDER STREET STORM SEWER

RECORD COPY

CITY OF CLEBURNE

CLEBURNE, TEXAS

1958

NOTE: ——— - - ——— DENOTES PROPERTY LINE G.C. & S.F. RAILROAD.

LOCATION PLAN

SCALE 1" = 100'

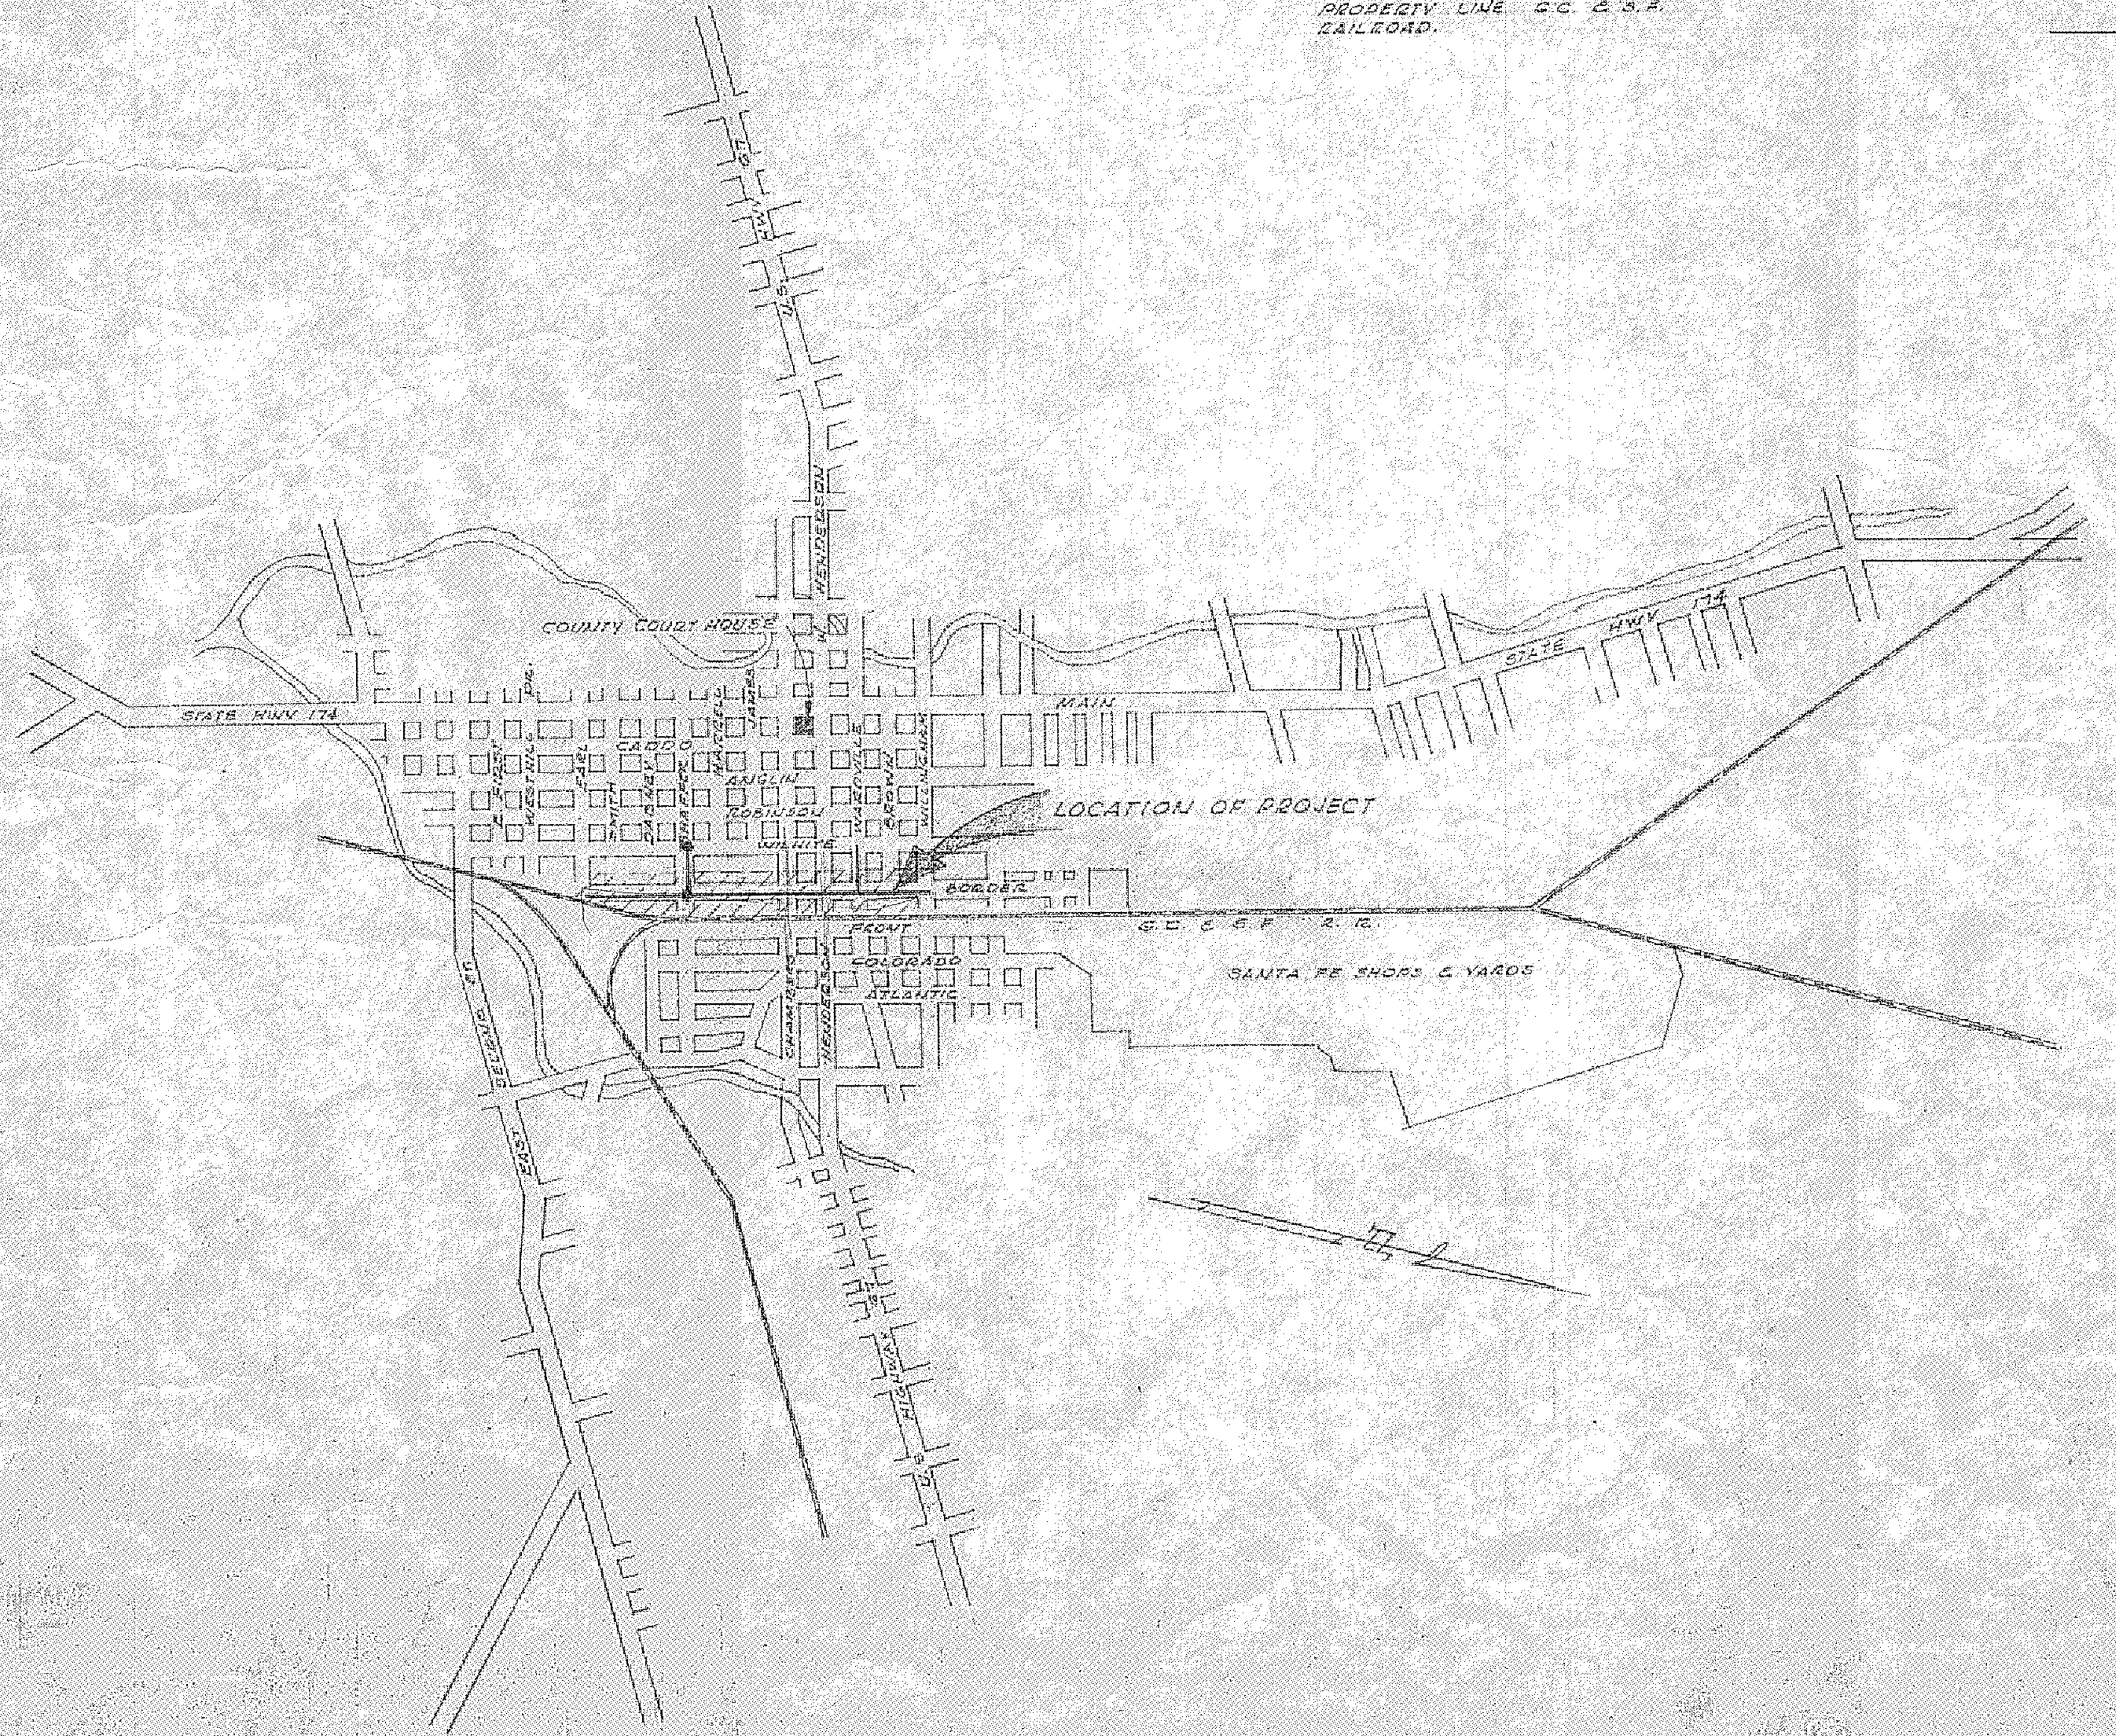

CITY OF CLEBURNE
CLEBURNE, TEXAS

DRAWN BY M.C.A.	BORDER STREET STORM SEWER
CHECKED BY A.S.	
APPR. BY F.J.C.	VICINITY MAP & LOCATION PLA
SCALE AS SHOWN	
DATE 9-58	PETE STYNER CITY ENGINEER

PLAN SCALE: 1"=20'

NOTE – TYPICAL TEST HOLE
0' TO 4 or 5' BLACK DIRT
5' TO 8' SANDY CLAY
8' TO 9' CLAY
ROCK AS NOTED

FB 485 PG 27

CITY OF CLEBURNE
CLEBURNE, TEXAS

DRAWN BY A.C.H.	BORDER STREET STORM SEWER
CHECKED BY R.S.	
APPR. BY P.M.S.	PROFILE
SCALE	BORDER STREET STA 28+00 TO
DATE 9-58	PETE STYNER CITY ENGINEER

CHARLES BRUNING COMPANY
PLAN PROFILE PLATE A
PRINTED IN U.S.A.
CHARLES BRUNING COMPANY
PLAN PROFILE PLATE A
PRINTED IN U.S.A.

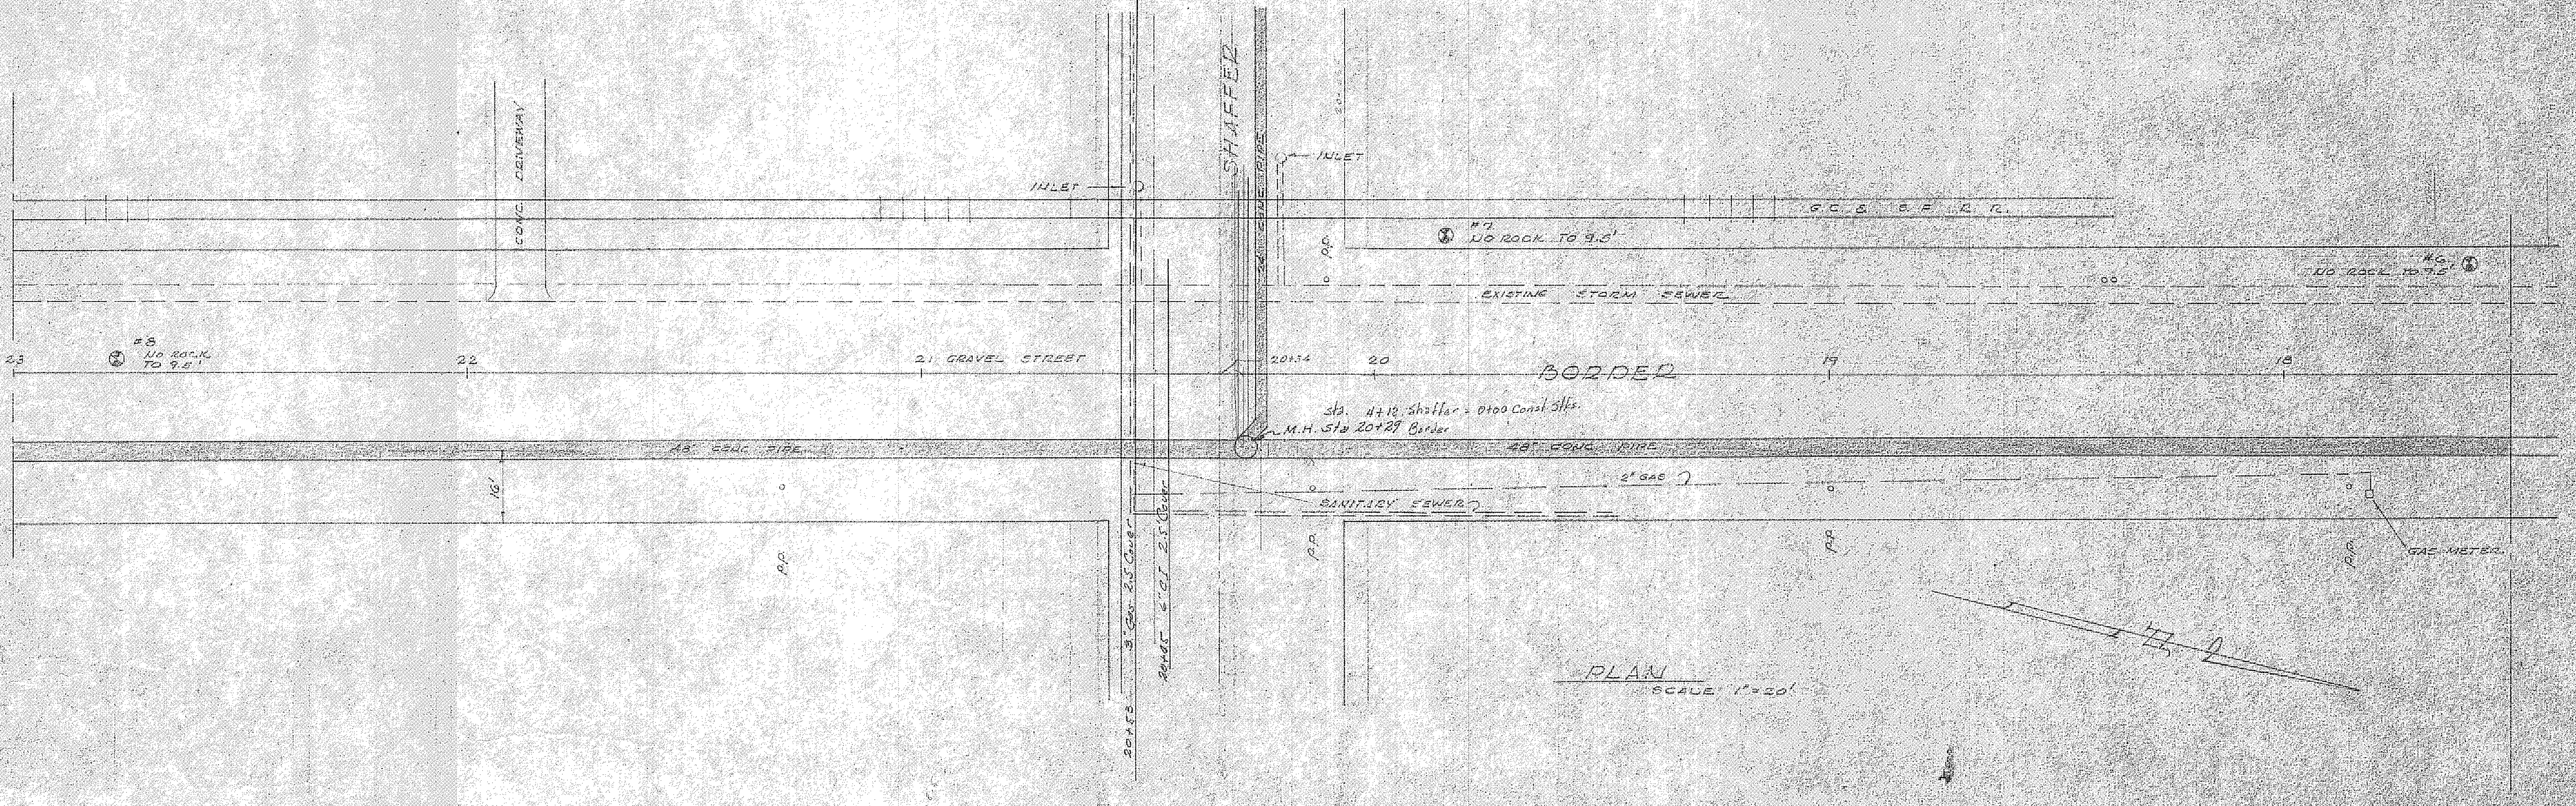

PLAN
SCALE 1" = 20'

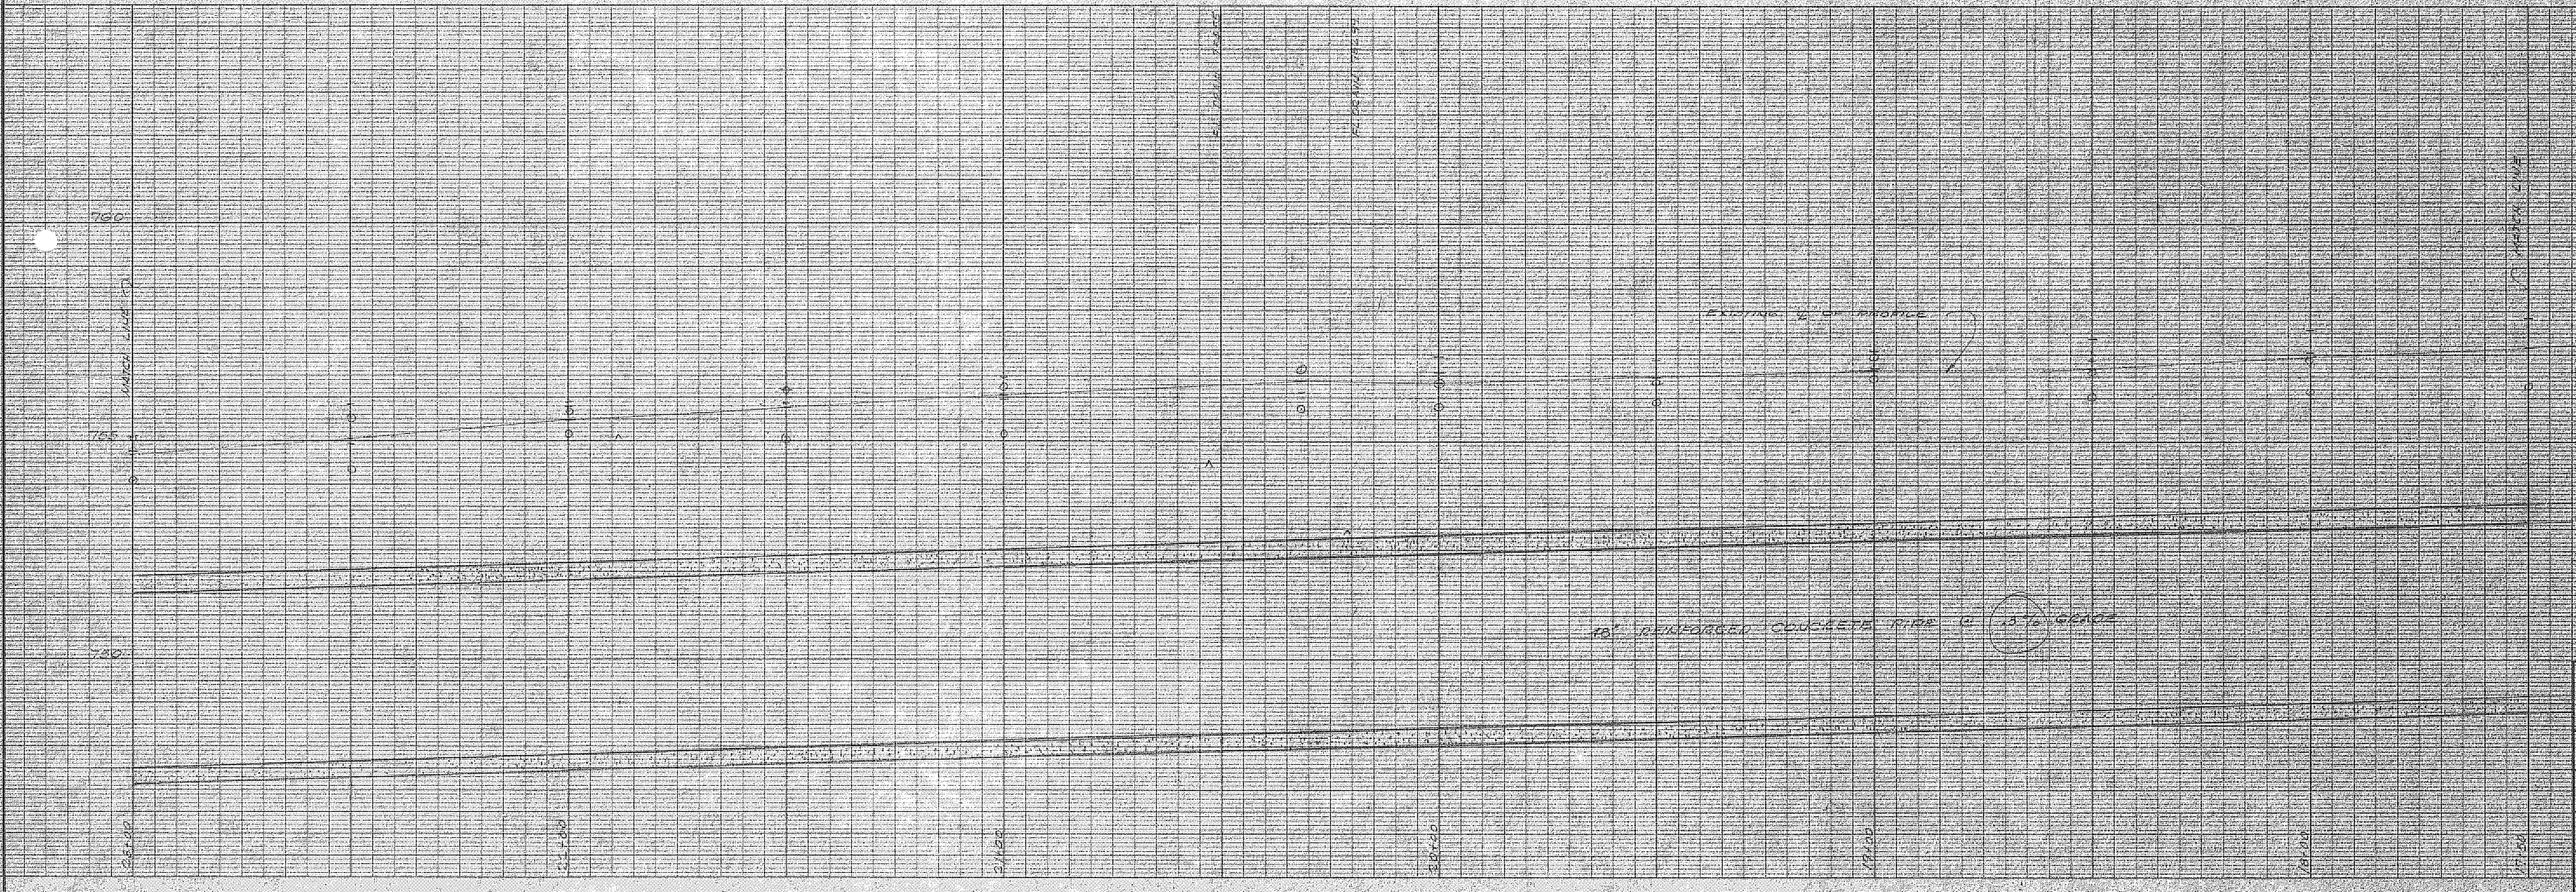

CITY OF CLEBURNE
CLEBURNE, TEXAS

DRAWN BY M.G.B.
CHECKED BY F.C.
APPR. BY

BORDER STREET
STORM SEWER

PROFILE
BORDER STREET STA. 17+50 TO 23+00

SCALE

DATE 11-58

PETE STYNER
CITY ENGINEER

SHEET 3

CHARLES BRUNING COMPANY
PLAN PROFILE PLATE A
PRINTED IN U.S.A.

CHARLES BRUNING COMPANY
PLAN PROFILE PLATE A
PRINTED IN U.S.A.

CHARLES BRUNING CO.
PLAN PROFILE PLATE
PRINTED IN U.S.A.

EXISTING 36" BRICK STORM SEWER
BUILDING
BORDER
P.P.
17
16
15
14
13
12
6" TRANSITE WATER
#5 NO ROCK TO 9.5' ⑤
SPECIAL EXCAVATION AS REQUIRED BY R.R.
G.C. & S.F. R.R.
TIE EXT. INLET INTO NEW STORM SEWER
INLET
CHAMBERS
EXISTING INLET TO BE MODIFIED TO ADD 6'-0 ADDITIONAL OPENING
STA 12+54 WATER VALVE
CURB HEADER
4" H.P. GAS
TIE EXISTING LINE AND INLET INTO NEW STORM SEWER
INLET 11+78
PAVED STREET - ASPHALT SURFACE-CONC BASE TO BE REPAIRED AS SPECIFIED
6" C.I. WATER MAIN
PLAN SCALE 1" = 20'
EXISTING GRD. PROFILE
MATCH LINE
760
755
750
48" REINFORCED CONCRETE PIPE @ .27% GRADE
17+00
16+00
15+00
14+00
13+00
12+00

CITY OF CLEBURNE
CLEBURNE, TEXAS

DRAWN BY
NCH

CHECKED BY
R.E.

APPR. BY
P.L.S.

SCALE
1" = 20' H
1" = 5' V

DATE
9-58

BORDER STREET
STORM SEWER

PROFILE
BORDER STREET STA 11+50 TO 17+00

PETE STYNER
CITY ENGINEER

SHEET 4
OF 9

CHARLES BRUNING COMPANY
PLAN PROFILE PLATE A
PRINTED IN U.S.A.

CHARLES BRUNING COMPANY
PLAN PROFILE PLATE A
PRINTED IN U.S.A.

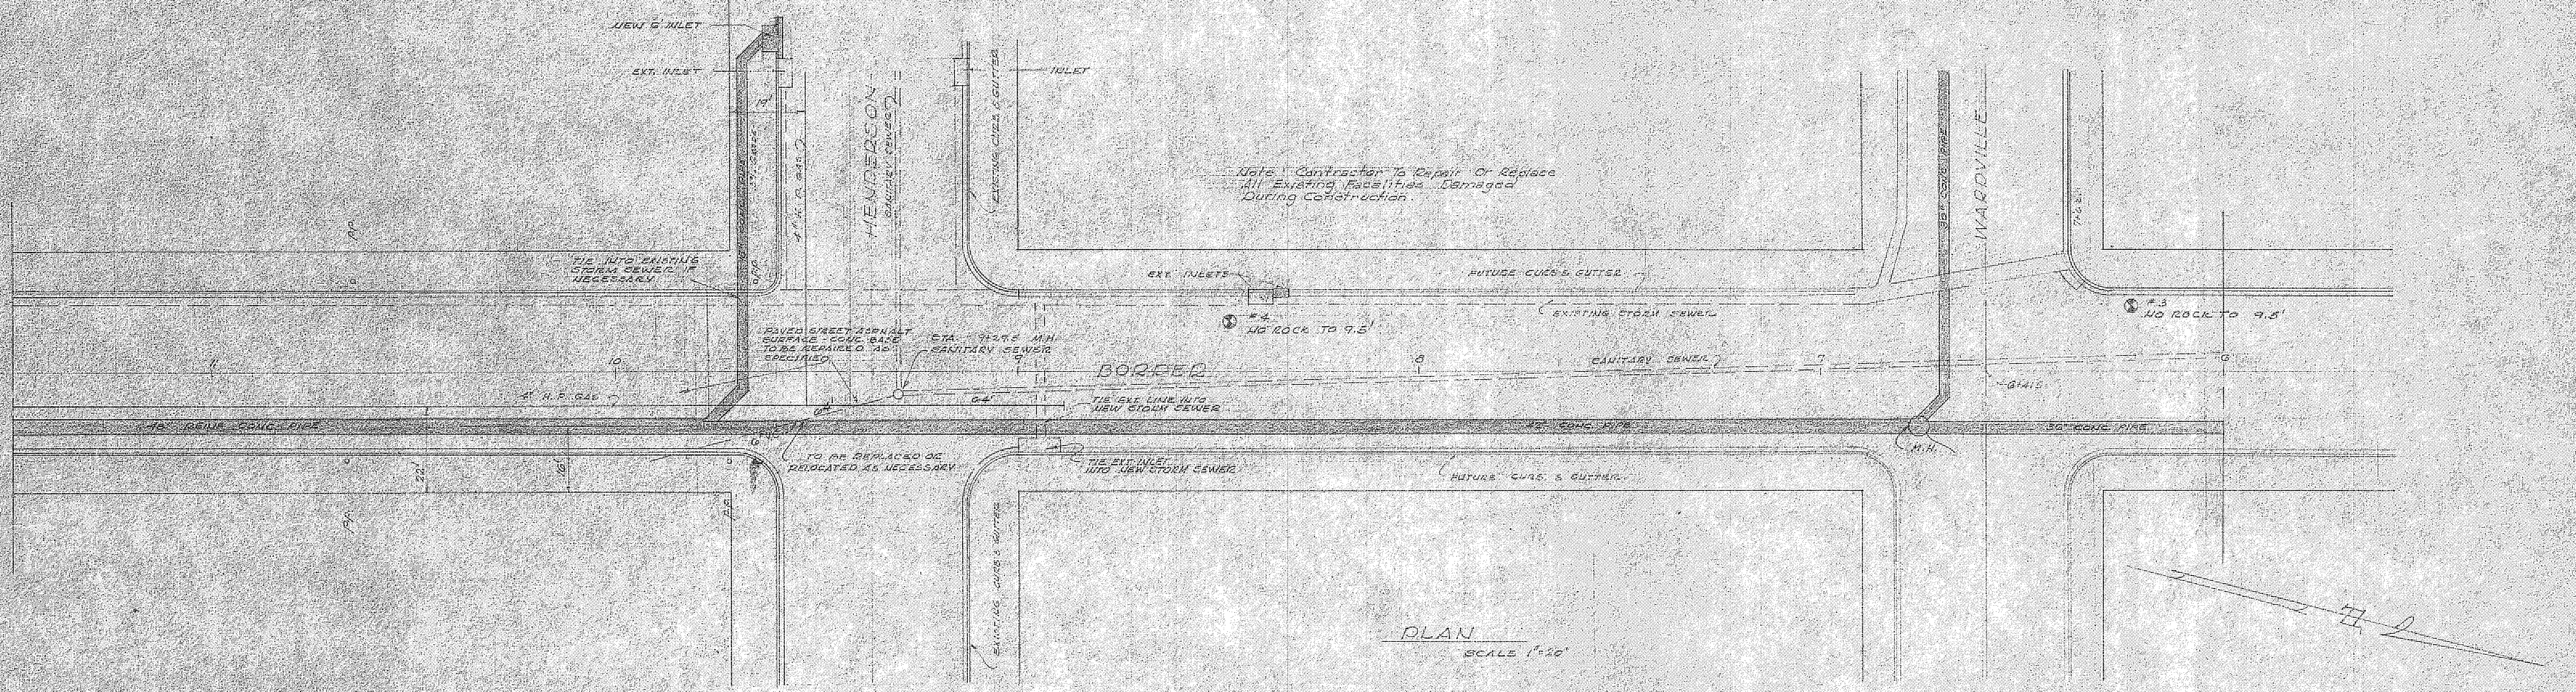
NEW 6' INLET
EXT. INLET
INLET
HENDERSON
SANITARY SEWER
4" H. P. GAS
EXISTING CURB & GUTTER
Note: Contractor To Repair Or Replace All Existing Facilities Damaged During Construction.
TIE INTO EXISTING STORM SEWER IF NECESSARY
PAVED STREET ASPHALT SURFACE - CONC. BASE TO BE REPAIRED AS SPECIFIED
STA. 9+75 M.H. SANITARY SEWER
EXT. INLETS
#4 NO ROCK TO 9.5'
FUTURE CURB & GUTTER
EXISTING STORM SEWER
BORDER
SANITARY SEWER
10
9
8
7
6
64'
TIE EXT. LINE INTO NEW STORM SEWER
48" REINF. CONC. PIPE
42" CONC. PIPE
30" CONC. PIPE
TO BE REPLACED OR RELOCATED AS NECESSARY
TIE EXT. INLET INTO NEW STORM SEWER
WARDVILLE
30" CONC. PIPE
M.H.
6+15
#3 NO ROCK TO 9.5'
22'
16'
P.P.

PLAN
SCALE 1"=20'

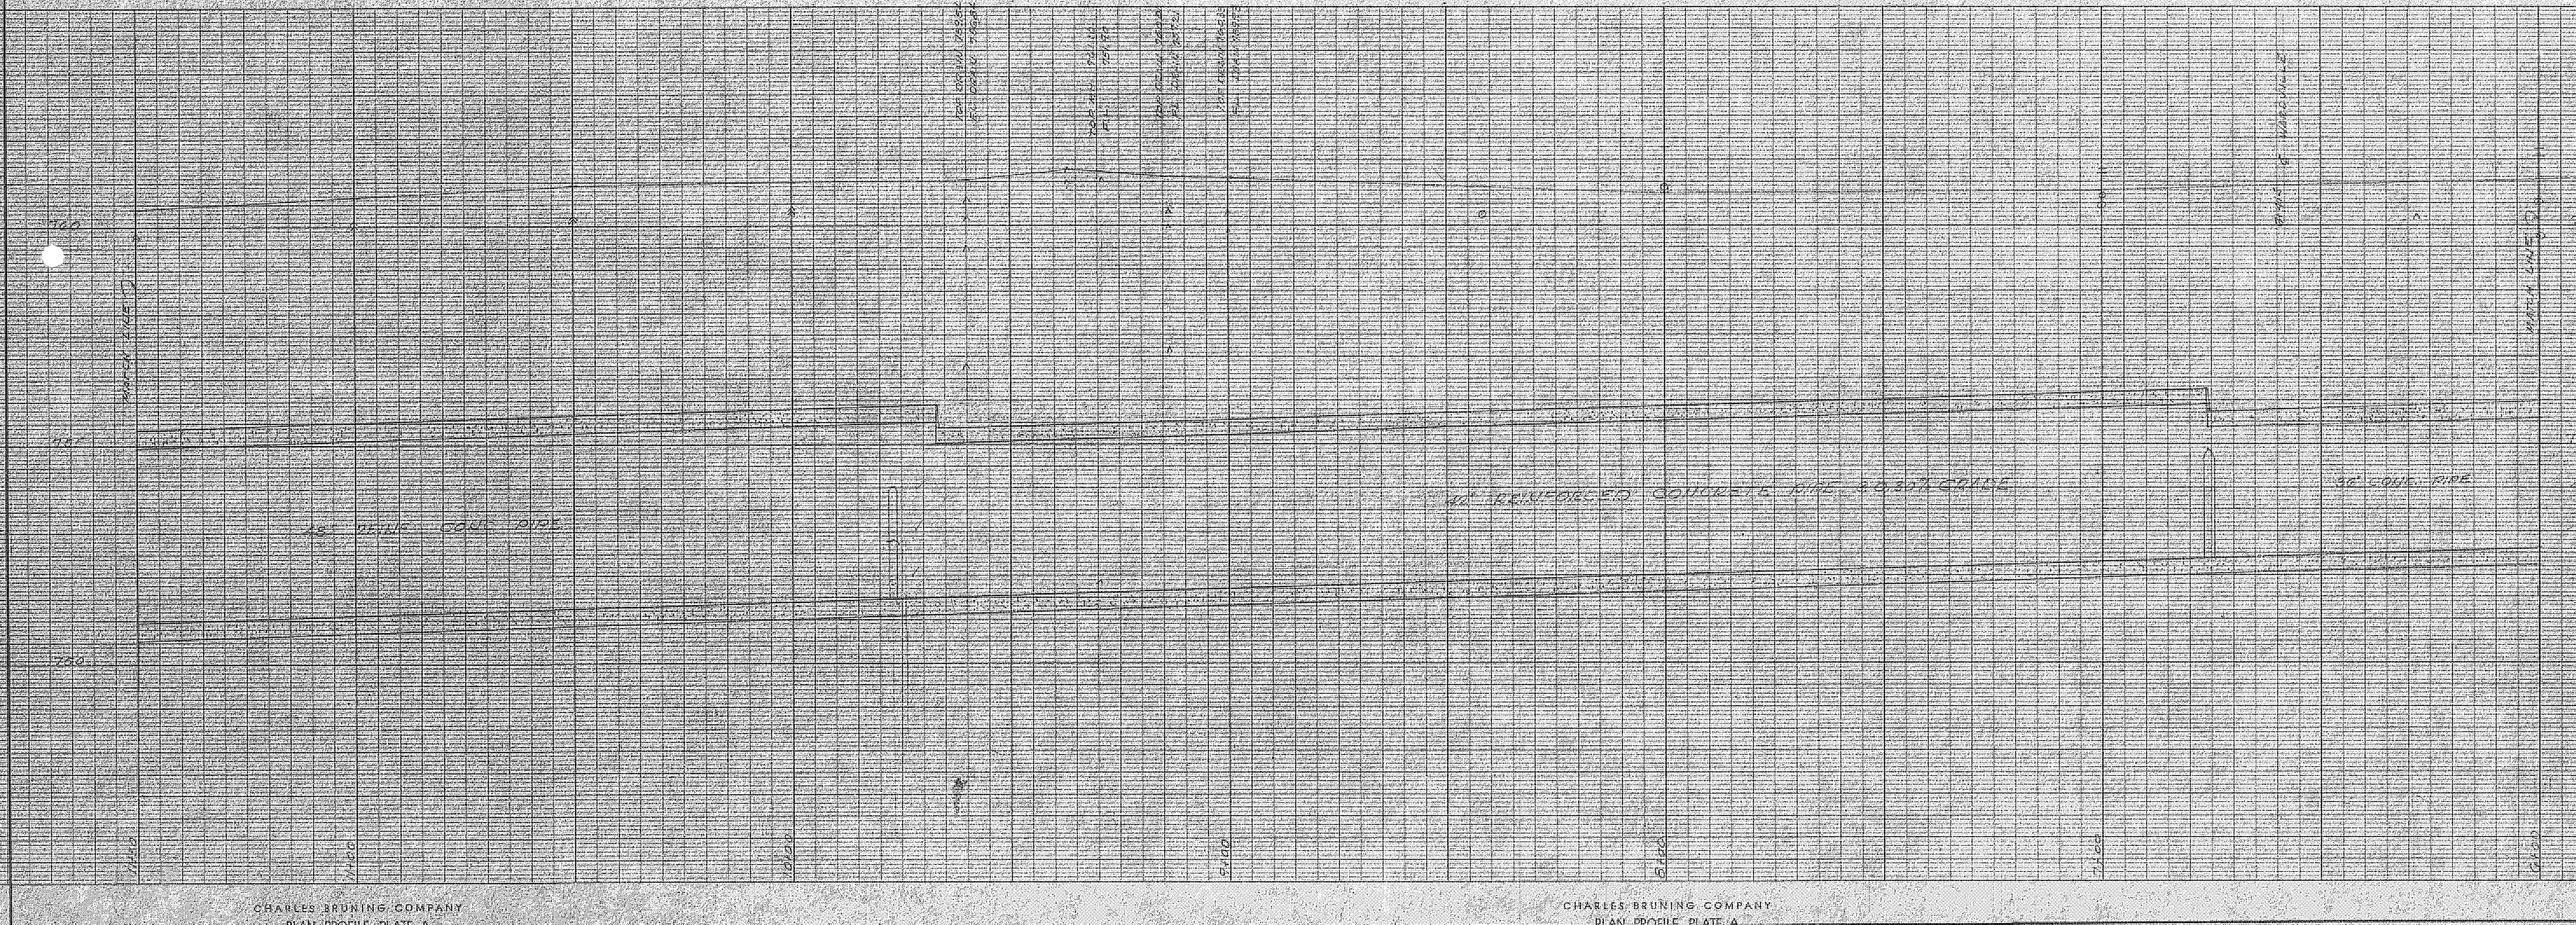

CITY OF CLEBURNE
CLEBURNE, TEXAS

DRAWN BY M.G.A.	BORDER STREET STORM SEWER
CHECKED BY P.S.	
APPR. BY [illegible]	PROFILE
SCALE	BORDER STREET STA. 6+00 TO 11+50
DATE 7-58	PETE STYNER CITY ENGINEER

SHEET 5
OF

CHARLES BRUNING COMPANY
PLAN PROFILE PLATE A
PRINTED IN U.S.A.

PLAN
SCALE 1" = 20'

CHARLES BRUNING COMPANY
PLAN PROFILE PLATE A

CITY OF CLEBURNE
CLEBURNE, TEXAS

DRAWN BY
W.S.A.

CHECKED BY
P.S.

APPR. BY

SCALE
1" = 20' H
1" = 2' V

DATE
7-58

BORDER STREET
STORM SEWER

PROFILE
BORDER STREET STA. 0+00 TO 6+00

PETE STYNER
CITY ENGINEER

SHEET 6
OF

CITY OF CLEBURNE
CLEBURNE TEXAS

DRAWN BY M.C.R.
CHECKED BY
APPR. BY
SCALE
DATE

BORDER STREET
STORM SEWER

PROFILE
EAST SHAFFER STREET

PETE STYNER
CITY ENGINEER

SHEET
OF

CHARLES BRUNING COMPANY
PLAN PROFILE PLATE A
PRINTED IN U.S.A.

Note: Grade Changes May Be Necessary In The Event Of Conflicting Grades.

CITY OF CLEBURNE
CLEBURNE, TEXAS

DRAWN BY M.C.H.	BORDER STREET STORM SEWER
CHECKED BY P.S.	
APPR. BY P.S.	PROFILE EAST WARDVILLE STREET
SCALE 1"=20' H	
DATE	PETE STYNER CITY ENGINEER
	SHEET 8 OF 9

CHARLES BRUNING COMPANY
PLAN PROFILE PLATE A
PRINTED IN U.S.A.